
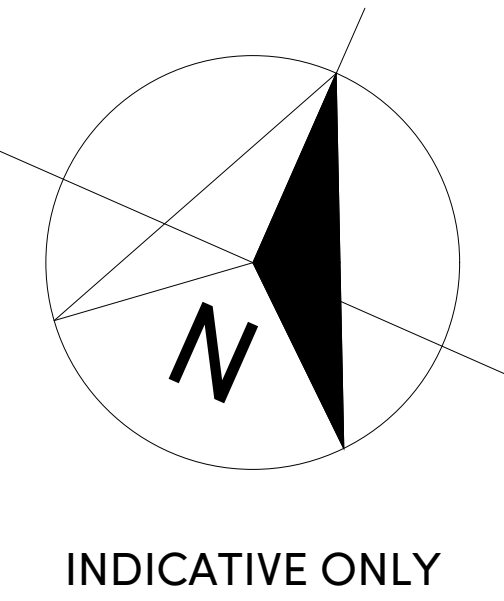


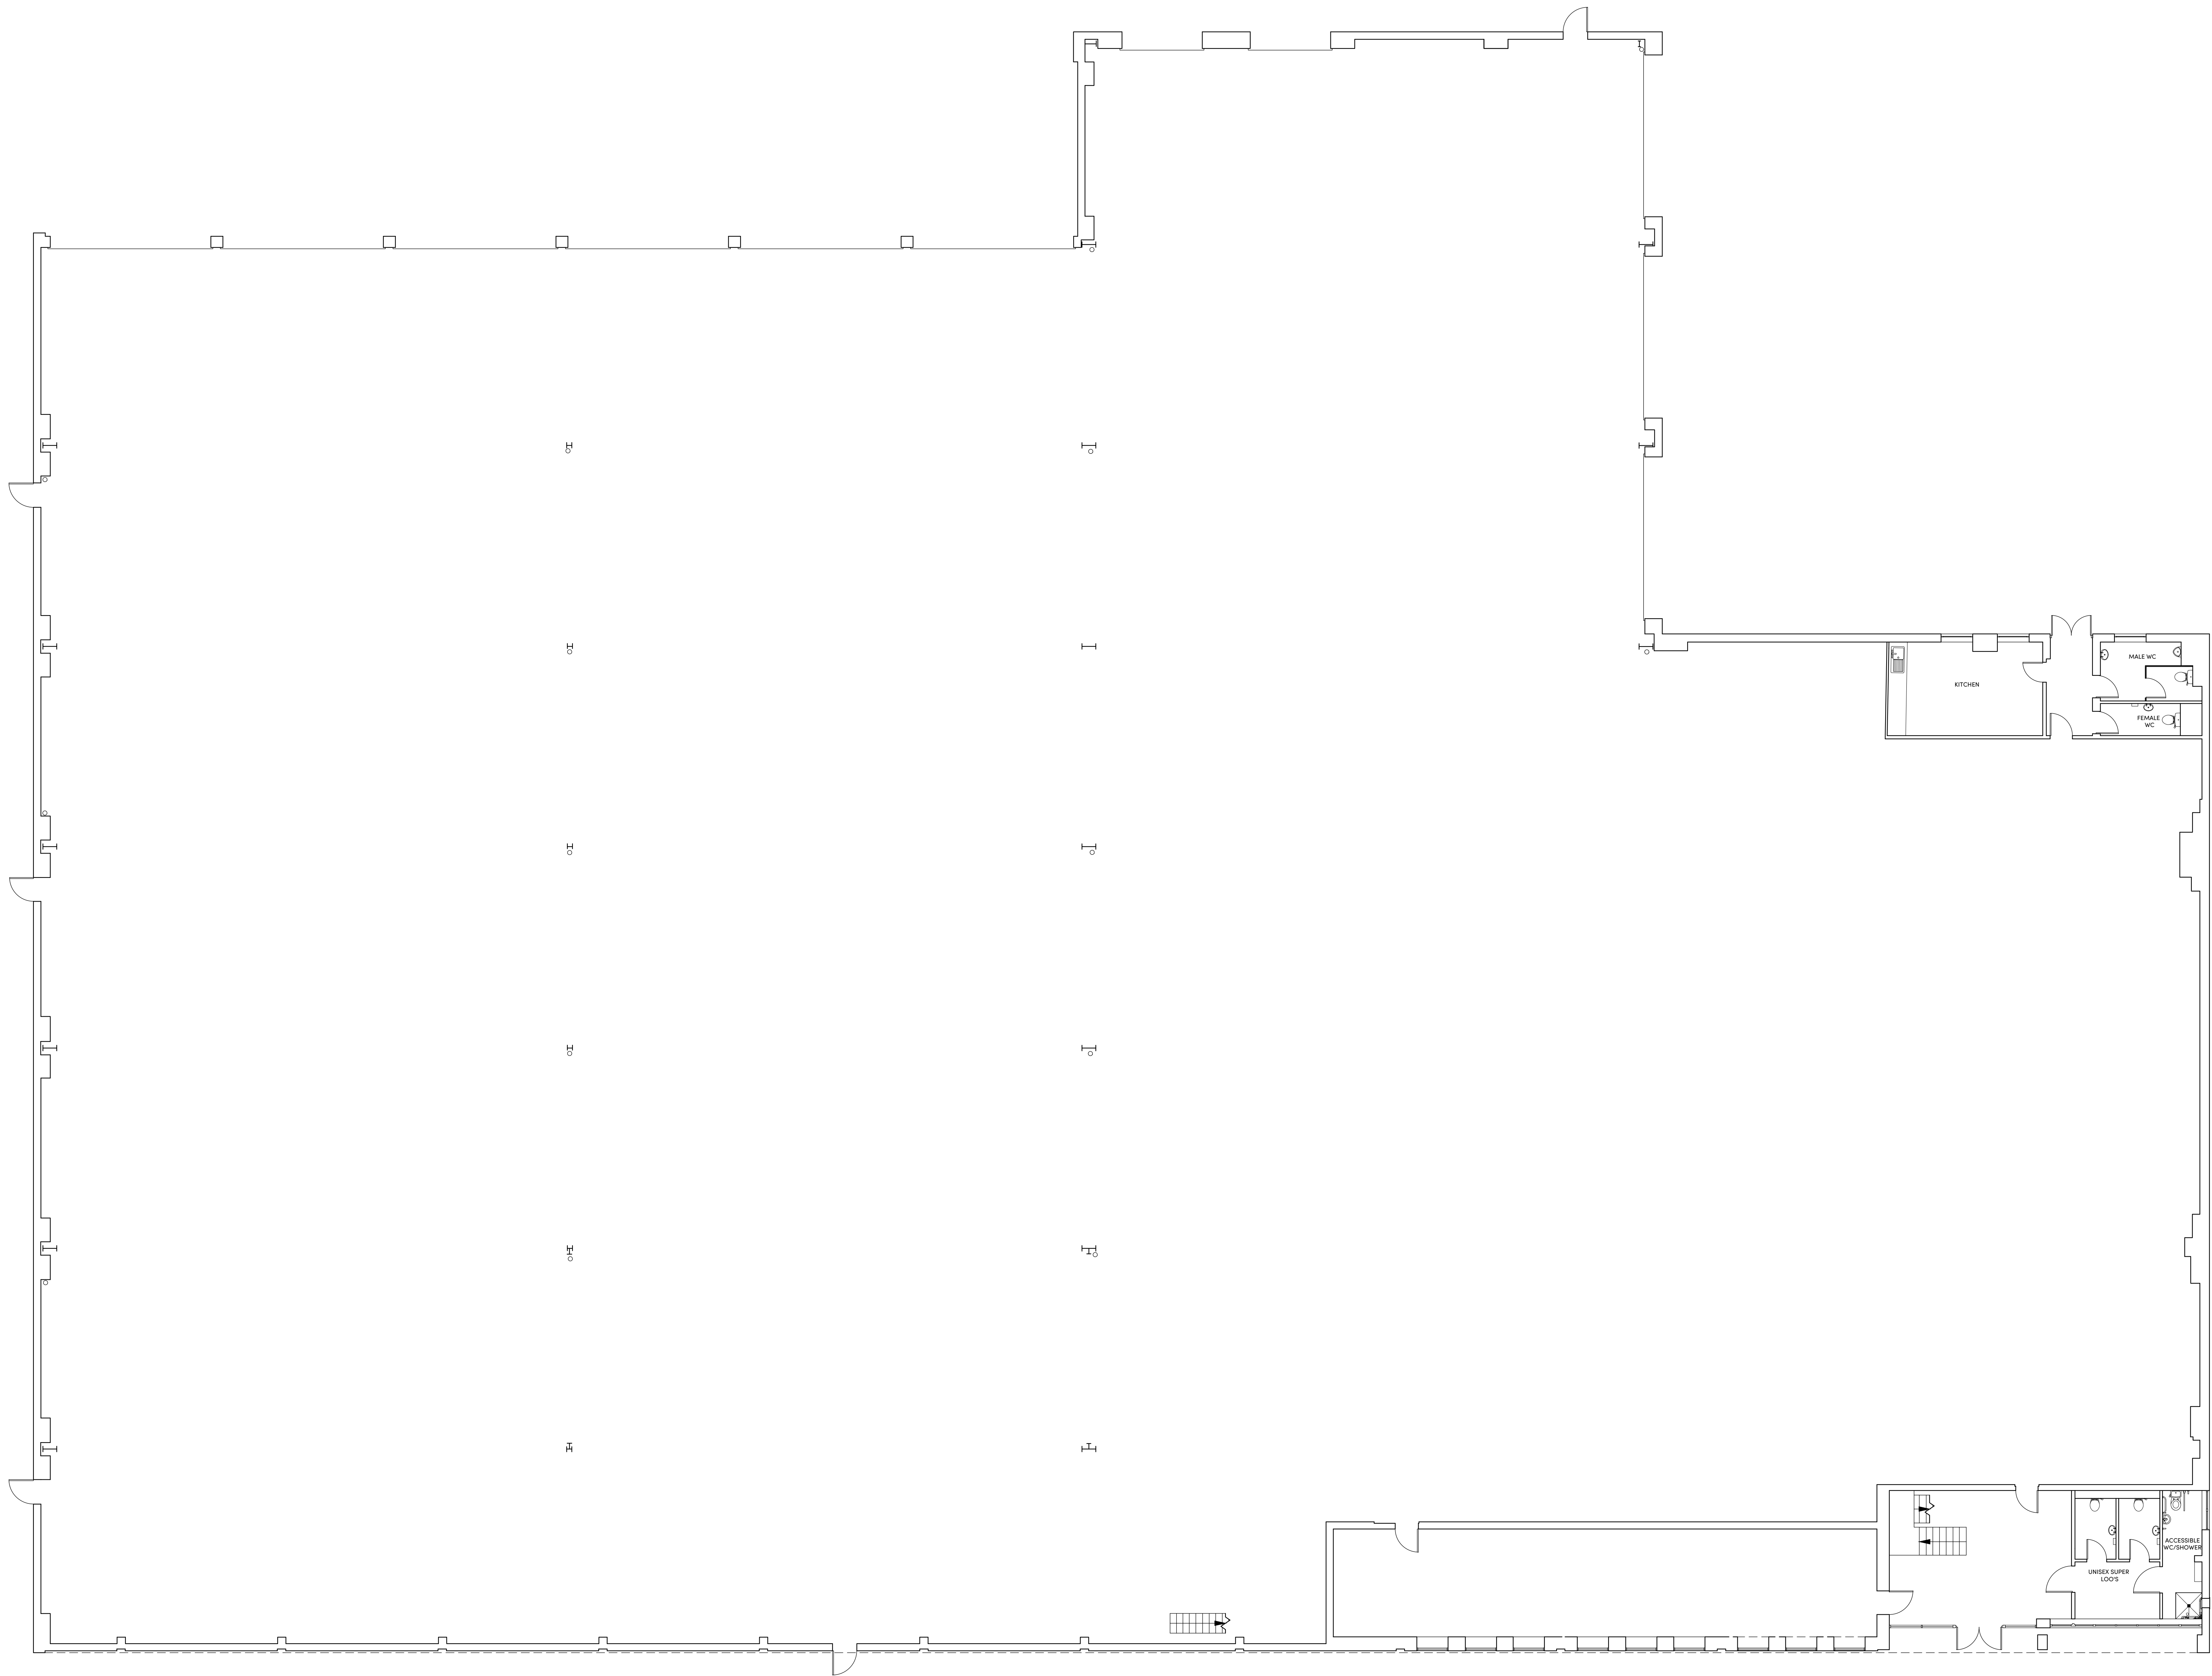

#### NOTES

- 1) ALL DIMENSIONS TO BE CHECKED ON SITE AND NOT SCALED FROM THIS DRAWING.
- 2) HOLLIS SHALL BE INFORMED IN WRITING OF ANY DISCREPANCIES.
- 3) ALL DIMENSIONS ARE IN METRES ONLY.
- 4) THE ORIGIN AND ORIENTATION OF THE SURVEY GRID RELATE TO A GPS TIE TO ORDNANCE SURVEY GRID.
- 5) ALL LEVELS ARE BASED ON A GPS TIE TO THE OSG360GB GEOD MODEL.

#### KEY

#### REVISIONS

| REV. | DATE | AMENDMENTS | INITIAL |
|------|------|------------|---------|
|      |      |            |         |
|      |      |            |         |
|      |      |            |         |

THIS DRAWING IS FOR THE FOLLOWING PURPOSE ONLY:  
PRELIMINARY ☐ TENDER ☐ CONSTRUCTION ☐  
SKETCH ☐ MEASURED SURVEY ☒ CONTRACT ☐

#### TITLE

#### AS-BUILT PLAN

#### CLIENT

Mileway Real Estate UK Limited  
3 Copthall Avenue  
London  
EC2R 7BH

#### PROJECT NAME

Unit 28  
North Way  
Andover  
SP10 5RW

**HOLLIS**  
140 London Wall  
London  
EC2Y 5DN



T +44 20 7622 9555  
W [hollisglobal.com](https://hollisglobal.com)

|                    |                     |                |                      |          |
|--------------------|---------------------|----------------|----------------------|----------|
| DATE<br>10.01.2023 |                     | DRAWN BY<br>AB |                      |          |
| SCALE<br>1:100 @A0 |                     | CHECKED<br>TP  |                      |          |
| PROJECT            | LINE                | ORIGINATOR     | VOLUME/<br>ZONE/BLDG | LEVEL    |
| 115355             | 100                 | HLS            | 00                   | 00       |
| FILE<br>TYPE       | DISCIPLINE/<br>ROLE | NUMBER         | STATUS               | REVISION |
| M2                 | B                   | 10250          | A7                   | C10      |